
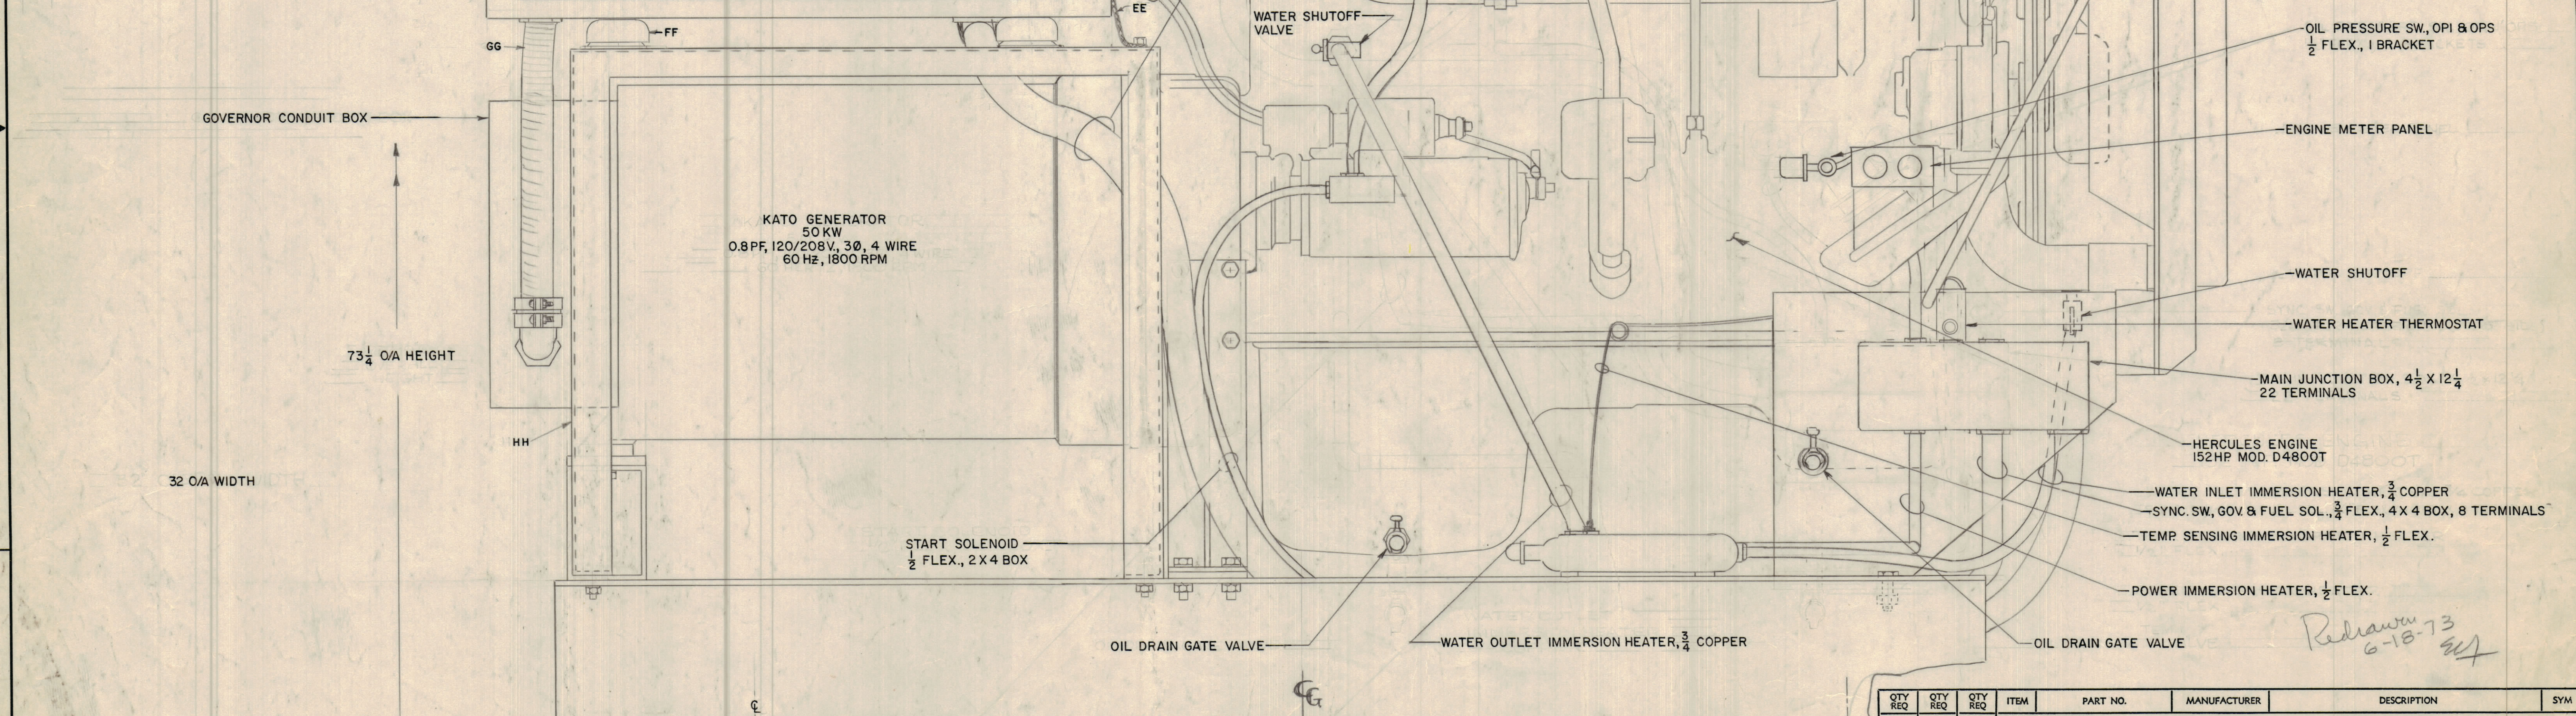


REVISIONS					
ZONE	LTR	DESCRIPTION	DATE	DRAFT	CHK'D APPD
A		ADDED COMPONENTS & CONDUIT	12-8-72	RM	JKM
B		AS BUILT	5/19/73	RM	JKM

- A- ELAPSED TIME METER
- B- VOLTMETER PHASE SELECTOR SWITCH
- C- VOLTMETER AC
- D- FREQUENCY METER
- E- AMMETER AC
- F- AMMETER PHASE SELECTOR SWITCH
- G- AMMETER DC
- H- DC CONTROL INDICATOR LIGHT (GREEN)
- I- EXTENDED LOAD INDICATOR LIGHT (AMBER)
- J- EMERGENCY STOP & CONTROL CUTOUT SWITCH
- K- NO LOAD TEST SWITCH (PB)
- L- LOAD TEST SWITCH (PB)
- M- EXTENDED LOAD STOP SWITCH (PB)
- N- VOLTAGE REGULATOR SWITCH
- O- VOLTAGE REGULATOR RHEOSTAT
- P- BATTERY CHARGER OVERLOAD BREAKER
- Q- BATTERY CHARGER SWITCH
- R- BATTERY CHARGER TEST SWITCH
- S- BATTERY EQUALIZING SWITCH (PB)
- T- VOLTMETER, FREQUENCY SELECTOR SWITCH
- U- START-STOP SWITCH (PB) LOAD BANK
- V- SAFETY RESET & LAMP TEST SWITCH
- W- OVERSPEED INDICATOR LIGHT (RED)
- X- OVER TEMPERATURE INDICATOR LIGHT (RED)
- Y- LOW OIL PRESSURE INDICATOR LIGHT (RED)
- Z- OVER CRANKING INDICATOR LIGHT (RED)
- AA- EXCITER FIELD RHEOSTAT
- BB- IMMERSION HEATER SWITCH
- CC- GENERATOR CIRCUIT BREAKER
- DD- DOOR LATCH
- EE- GROUNDING STRAP
- FF- SHOCK ABSORBER
- GG- FLEXIBLE CONDUIT
- HH- TABLE SADDLE
- II- FREQUENCY ADJUST RHEOSTAT

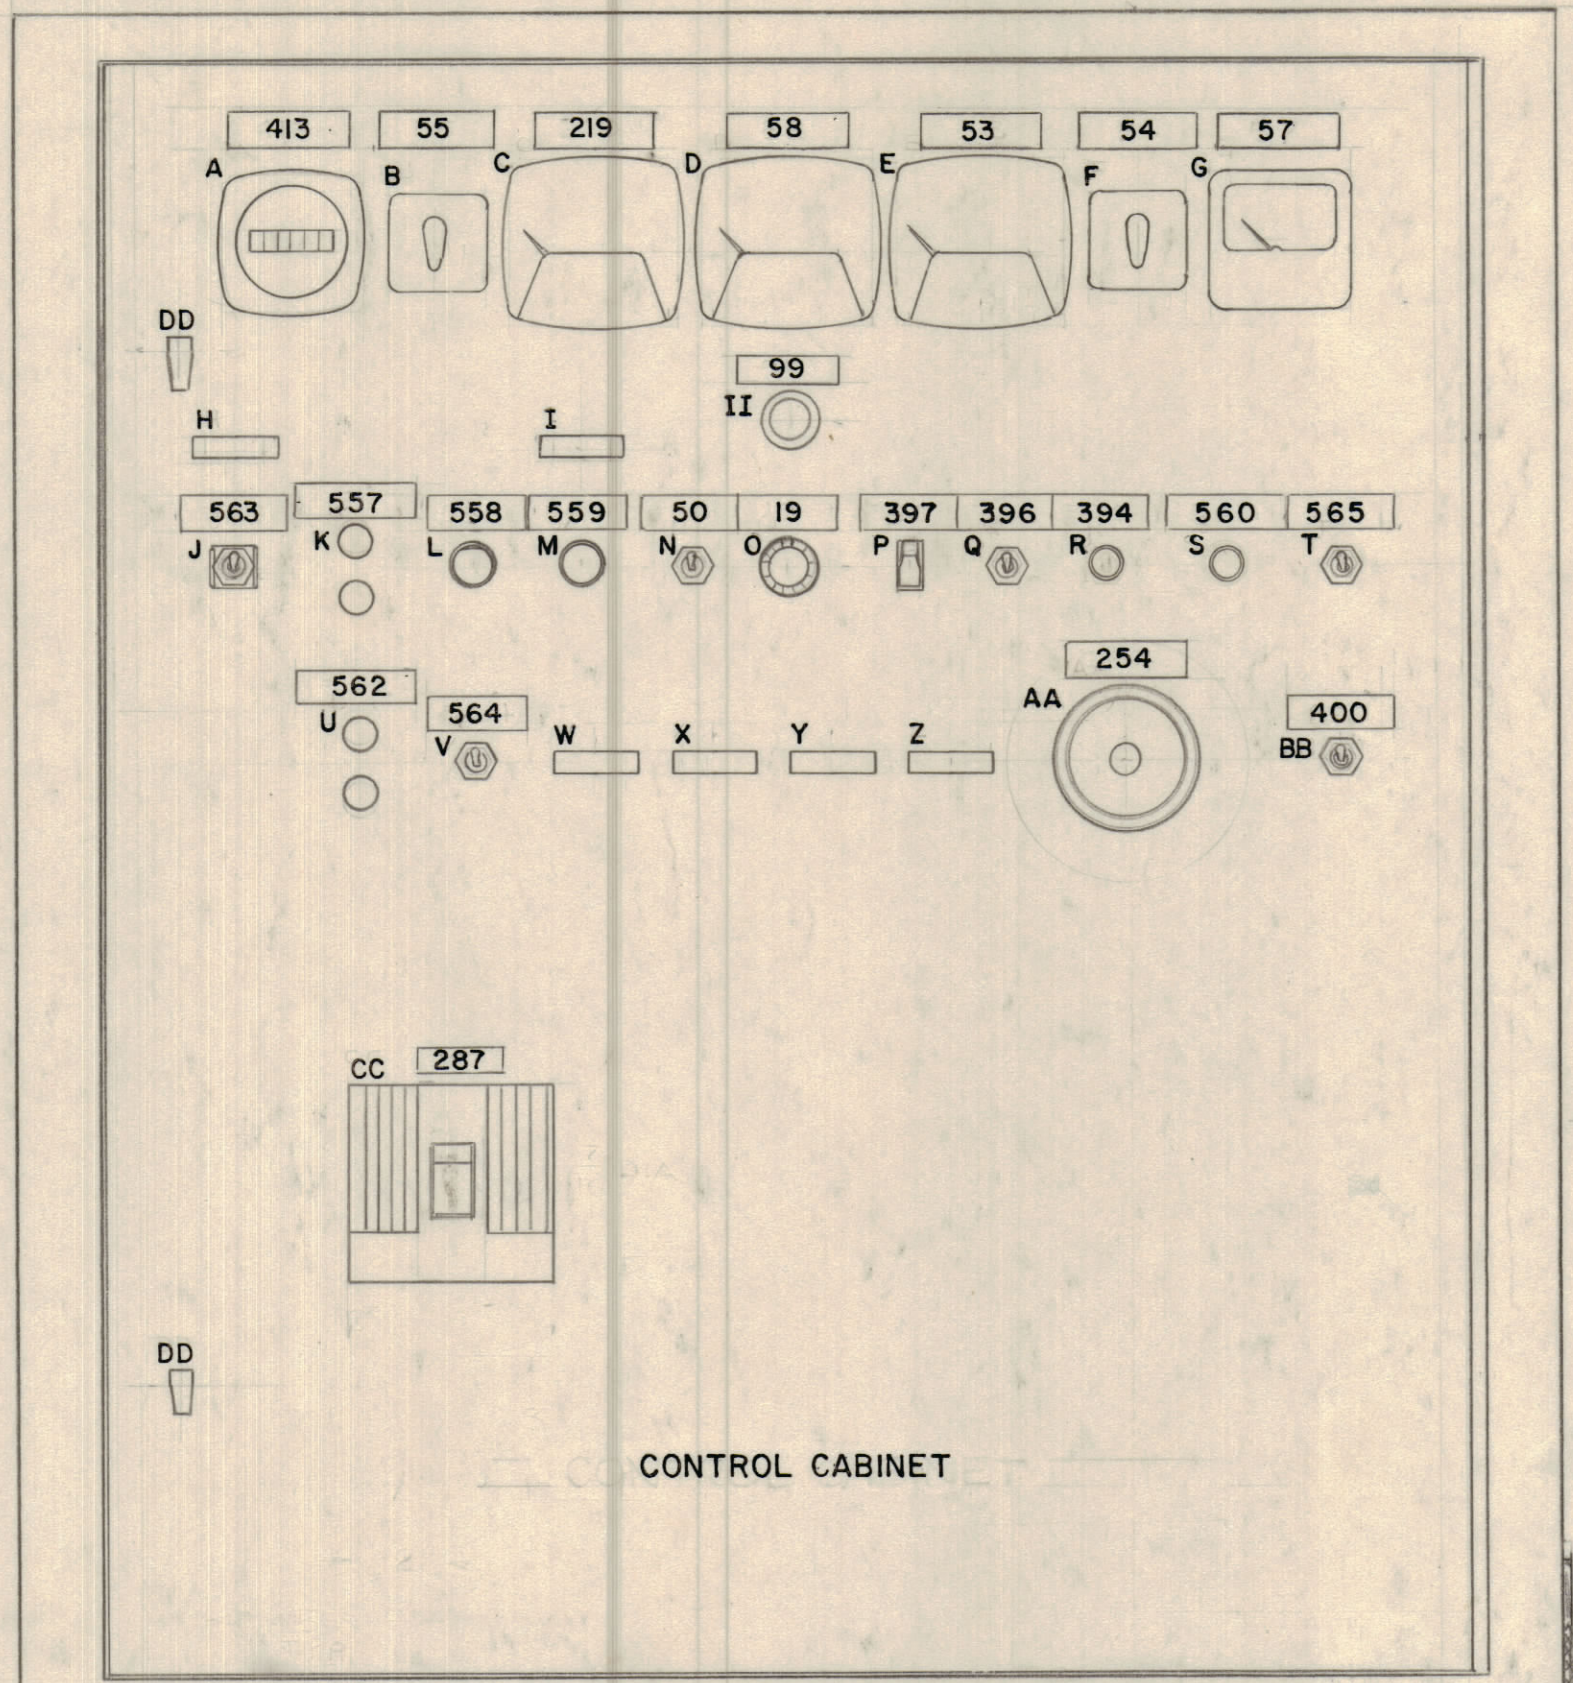

QTY REQ	QTY REQ	QTY REQ	ITEM	PART NO.	MANUFACTURER	DESCRIPTION	SYM	
			PARTS LIST					
			DRAWN	MITCH	DATE	3-8-72	<b>THE TMC SYSTEMS AND POWER CORPORATION</b> SPRINGFIELD, VIRGINIA  <b>50 KW ENGINE GENERATOR</b> SIDE ELEVATION FAA	
			CHECKED		DATE			
			D. ENG.		DATE	3-8-72		
			P. ENG.		DATE			
			P. MGR.		DATE			
			CHIEF, ENG. DEPT.		DATE			
			SIZE	CODE IDENT NO	DWG. NO.		REV	
			D	24146	AX718		B	
			SCALE				SHEET 1 OF 2	

**INTERPRET DRAWING PER LISTED DOCUMENTS**

DIMENSIONING  
MIL - STD - 8  
SURFACE ROUGHNESS  
MIL - STD - 10  
ABBREVIATIONS  
MIL - STD - 12  
ELECTRONIC SYMBOLS  
MIL - STD - 15  
WELDING SYMBOLS  
JAN - STD - 19

**NOTICE TO PERSONS RECEIVING THIS DRAWING**  
 THE TMC SYSTEMS AND POWER CORPORATION claims proprietary right in the material disclosed herein. This drawing is issued in confidence for engineering information only and may not be reproduced or used to manufacture anything shown hereon without permission from THE TMC SYSTEMS AND POWER CORPORATION to the user. This drawing is loaned for mutual assistance and is subject to recall at any time.

*Redrawn 6-18-73*