


☒ OF FLOOR BEAMS

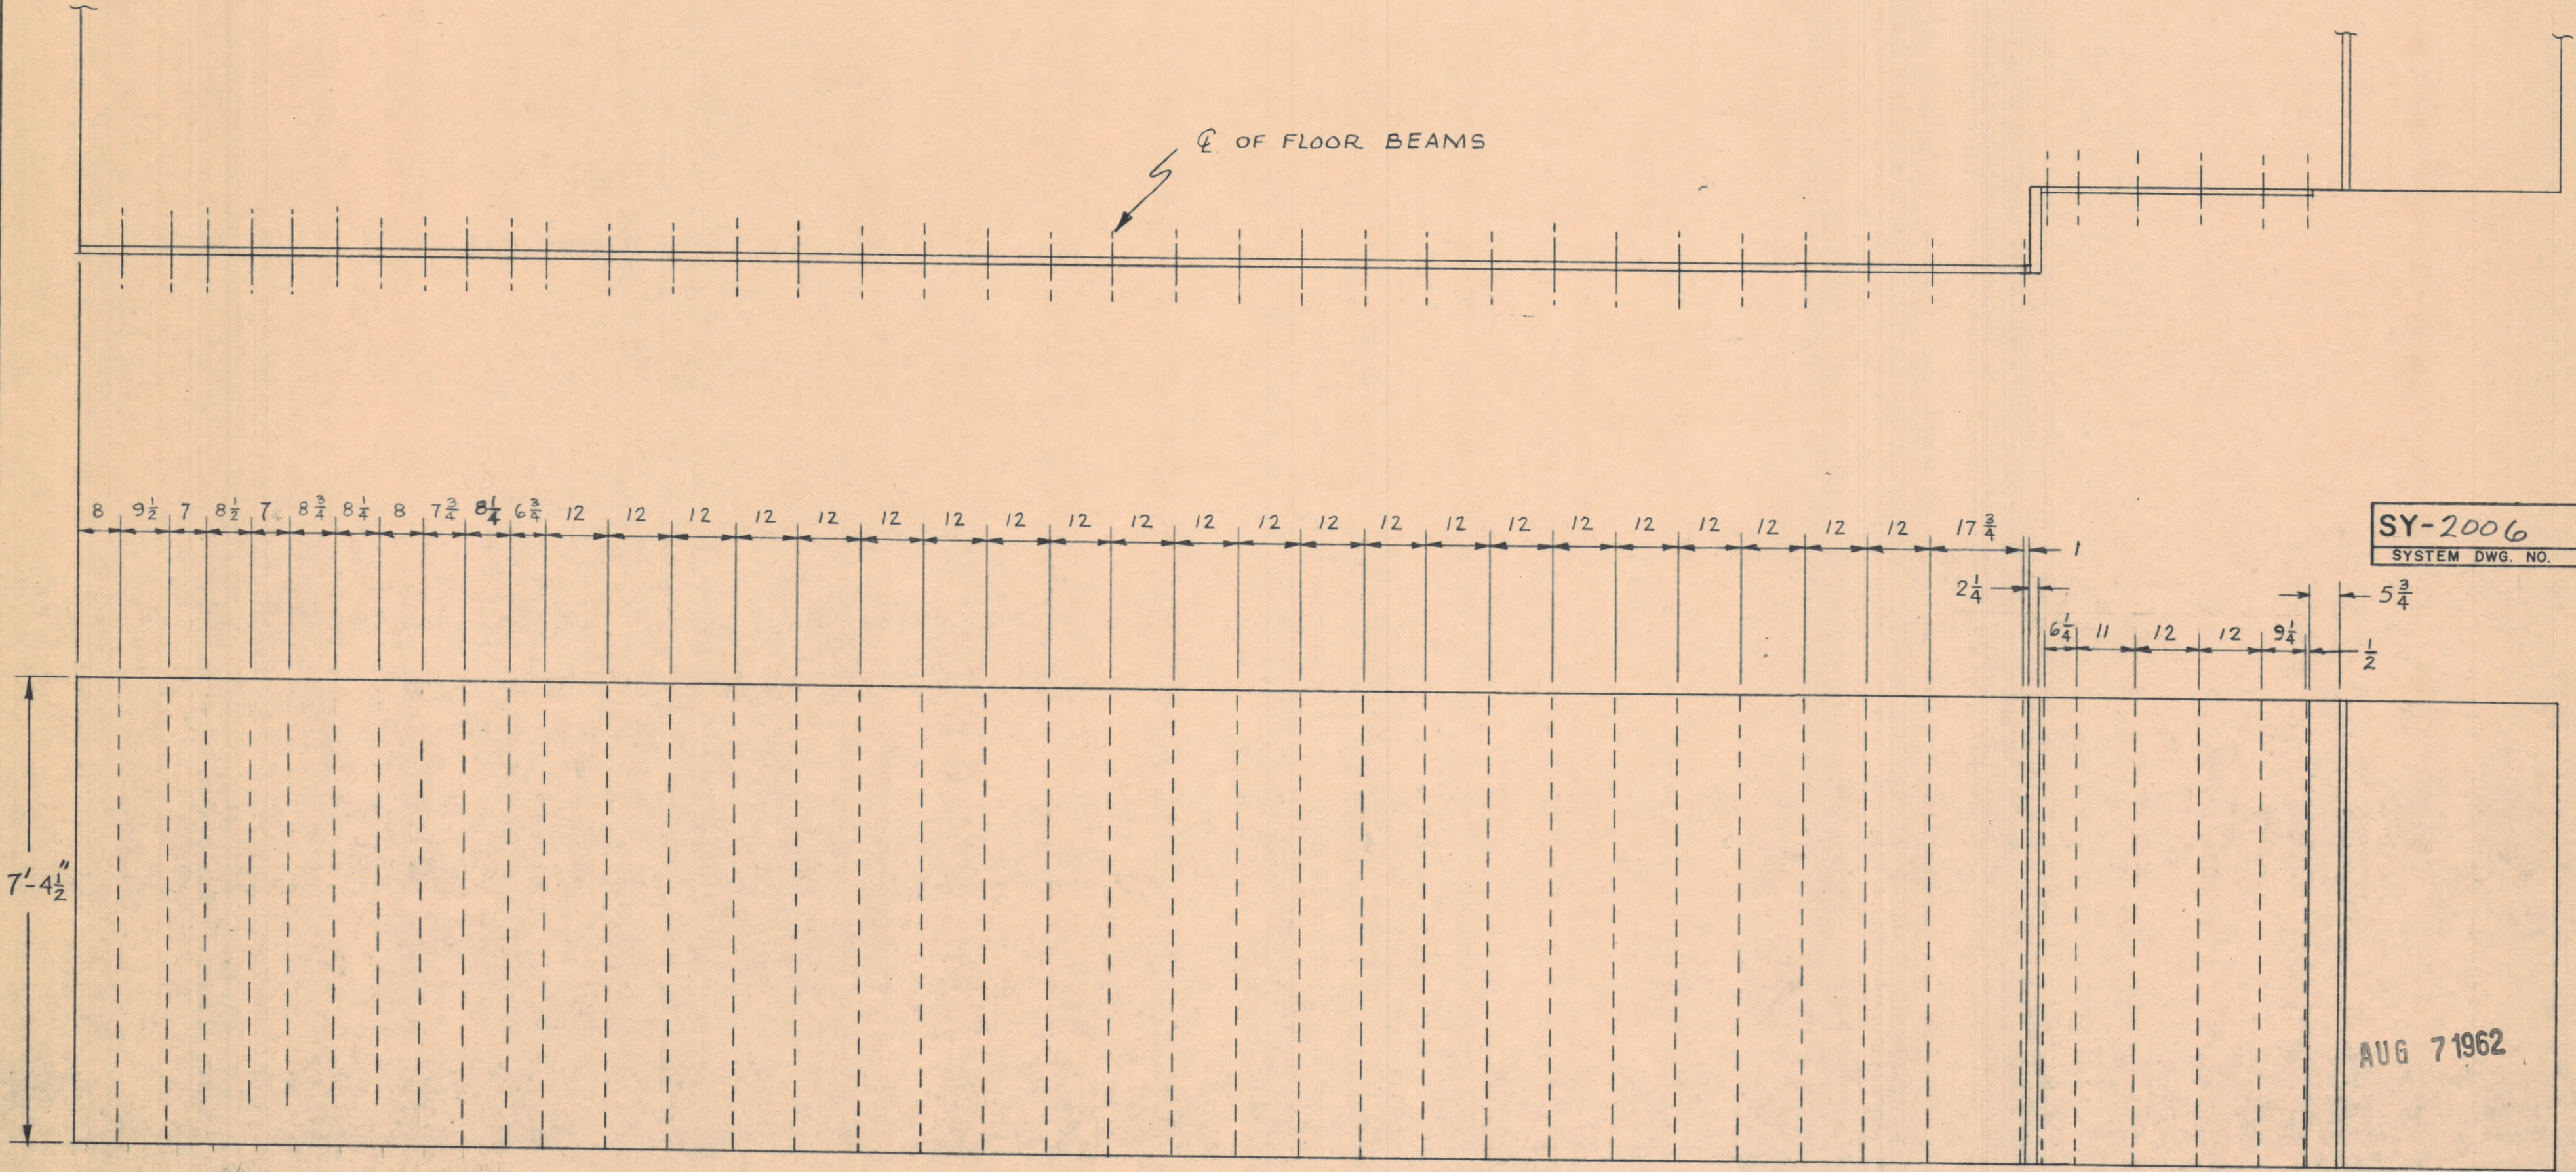

SY-2006
SYSTEM DWG. NO. NO. OF SH.

AUG 7 1962

OUT TO VIRGINIA

FOR SALES USE ONLY NOT FOR MANUFACTURING

STOCK SIZE		THE TECHNICAL MATERIEL CORP. MAMARONECK, NEW YORK SYSTEMS DEPARTMENT			
MATERIAL		SALES ORDER NUMBER	PROPOSAL NUMBER	QR NUMBER	
TYPE & TEMPER HEAT TREAT. SPEC.		TITLE: SYM-2001 PROJECT VAN FLOOR PLAN OF 40' VAN AS BUILT BY FRUEHAUF			
FINISH & SPEC NO.		MJT	4-21-61	SY-2006	
		DRAWN BY	DATE	FINAL APPROVAL	SYSTEM DWG. NO. NO. OF SH.

SCALE 1/2" = 1'